



FIRST FLOOR PLAN SHOWING CONCRETE SLAB JOINTS
SCALE 1/8" = 1'-0"

ROOM FINISH SCHEDULE					
FINISH NO.	FLOOR	BASE	WALL	CEILING	REMARKS
1	15/16" ASP. TILA.		MASONRY PAINTED	GYPSUM BOARD	
2	1/4" ASP. TILA.		MASONRY PAINTED	GYPSUM BOARD	
3	ABRASION CONC.	CONC. BASE	CEMENT PLASTER	CEM. ASB. BOARD	
4	ABRASION CONC.	CONC. BASE	CEMENT PLASTER	CEM. ASB. BOARD	
5	TROWELED SLAB		MASONRY PAINTED	GYPSUM BOARD	
6	STD. TOPPING		MASONRY PAINTED	GYPSUM BOARD	
7	TROWELED SLAB		MASONRY PAINTED	EXPOSED BRST	
8	TROWELED SLAB		MASONRY PAINTED	CONCRETE SLAB	
9	STD. TOPPING		MASONRY PAINTED	CEM. ASB. BOARD	

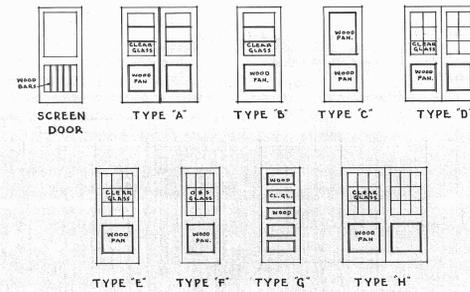


DOOR SCHEDULE

MARK	TYPE	SIZE	THICK	REMARKS
1	A	2'-2 1/2" x 6'-6"	1 3/4"	SCREEN DOOR
2	A	2'-2 1/2" x 6'-6"	1 3/4"	SCREEN DOOR
3	B	3'-0" x 6'-6"	1 3/4"	SCREEN DOOR
4	B	3'-0" x 6'-6"	1 3/4"	SCREEN DOOR
5	A	1'-2'-6" x 6'-6"	1 3/4"	SCREEN DOOR
6	A	1'-2'-6" x 6'-6"	1 3/4"	SCREEN DOOR
7	B	3'-0" x 6'-6"	1 3/4"	SCREEN DOOR
8	B	3'-0" x 6'-6"	1 3/4"	SCREEN DOOR
9	A	1'-2'-6" x 6'-6"	1 3/4"	SCREEN DOOR
10	A	1'-2'-6" x 6'-6"	1 3/4"	SCREEN DOOR
11	B	3'-0" x 6'-6"	1 3/4"	SCREEN DOOR
12	B	3'-0" x 6'-6"	1 3/4"	SCREEN DOOR
13	B	3'-0" x 6'-6"	1 3/4"	SCREEN DOOR
14	C	3'-0" x 6'-6"	1 3/4"	SCREEN DOOR
15	C	2'-4" x 6'-6"	1 3/4"	SCREEN DOOR
16	STEEL	3'-0" x 6'-6"		STEEL PLATE
17	D	2'-2 1/2" x 6'-6"	1 3/4"	SCREEN DOOR
18	D	2'-2 1/2" x 6'-6"	1 3/4"	SCREEN DOOR
19	D	1'-2'-6" x 6'-6"	1 3/4"	SCREEN DOOR
20	C	2'-4" x 6'-6"	1 3/4"	SCREEN DOOR
21	E	3'-0" x 6'-6"	1 3/4"	SCREEN DOOR
22	C	2'-4" x 6'-6"	1 3/4"	SCREEN DOOR
23	F	2'-4" x 6'-6"	1 3/4"	SCREEN DOOR
24	C	2'-4" x 6'-6"	1 3/4"	SCREEN DOOR
25	C	2'-4" x 6'-6"	1 3/4"	SCREEN DOOR
26	F	2'-4" x 6'-6"	1 3/4"	SCREEN DOOR
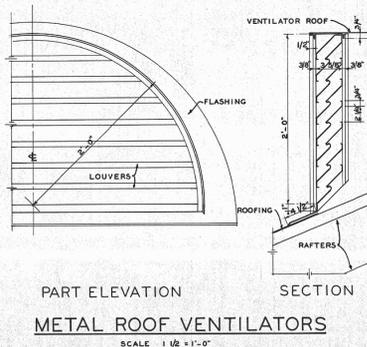

PART ELEVATION SECTION
METAL ROOF VENTILATORS
SCALE 1/8" = 1'-0"

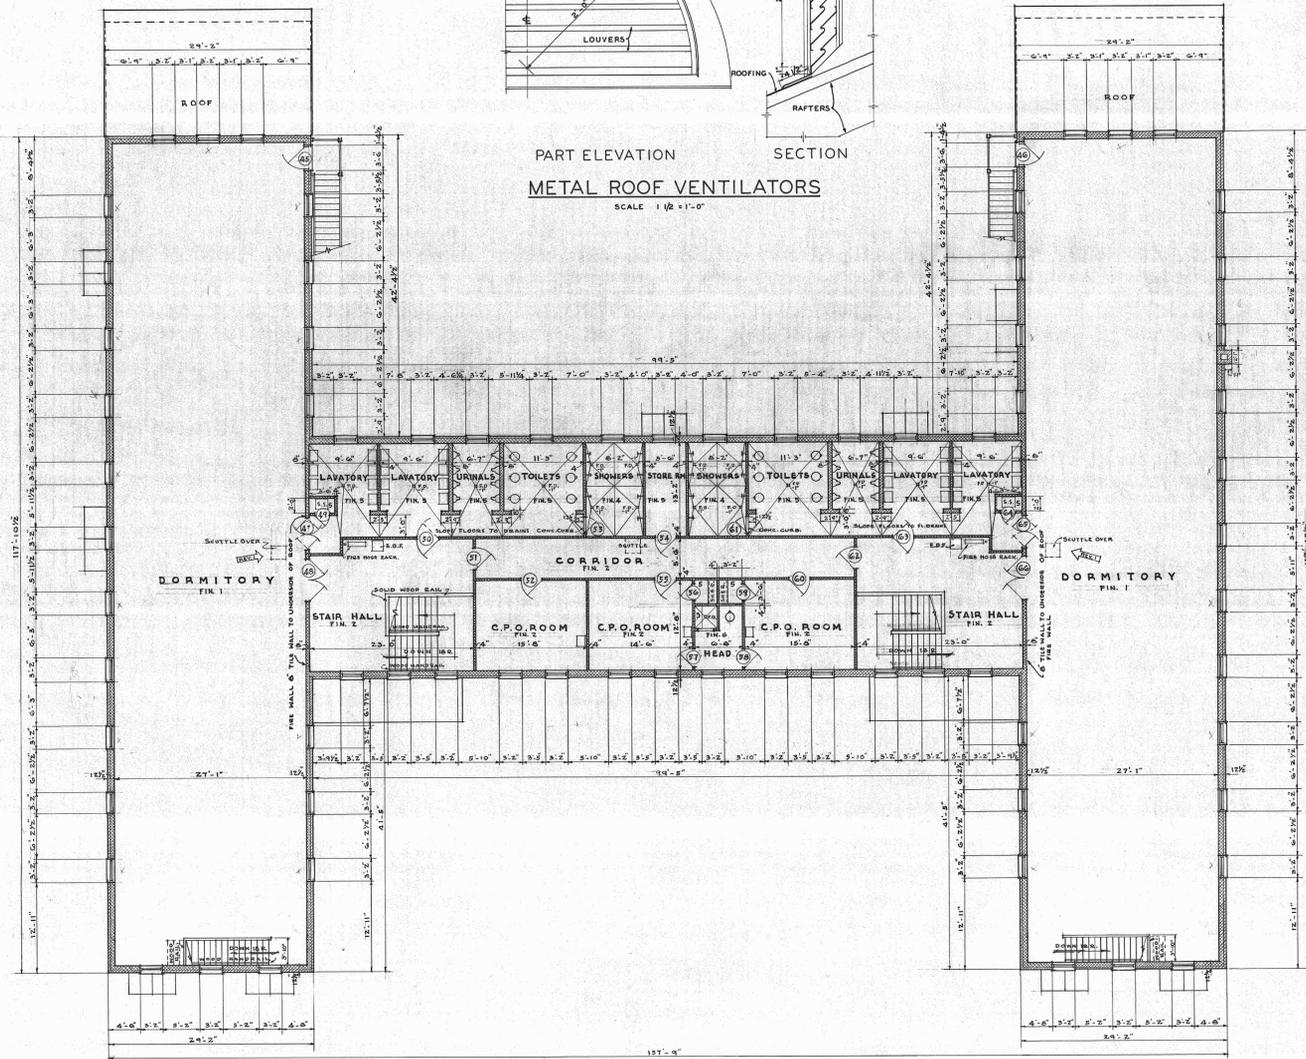

SECOND FLOOR PLAN
SCALE 1/8" = 1'-0"

RECORD DRAWING
SHEET 1 OF 27
SEE LETTER NO. 9209 DATED 3/29/46

REVISION	DATE	ADDED	BY	P.C.H.
1	6-18-45	ADDED 2 SCUTTLES		

REVIEWED BY:	J. N. PEASE & COMPANY, INC.
PROJECT NO.:	ENGINEERS ARCHITECTS CHARLOTTE, N. C.
	MARINE BARRACKS - PARRIS ISLAND, S. C.
	NAVY DEPT. - BUREAU OF YARDS & DOCKS
DRAWN BY:	L.W.D.
TRACED BY:	L.W.D.
CHECKED BY:	J.A.S.
DATE:	APRIL 20, 1946
CONTRACT NO.:	NOy-9209
SPECIFICATION NO.:	13763
APPROVED:	<i>[Signature]</i>
DATE:	7 27 1946
SHEET:	7 OF 27
V. & E. DWG. NO.:	332397

610-33-313

This drawing is a reproduction of an original 1946 construction drawing by J. N. Pease and Company, Inc. The original is held by Marine Corps Recruit Depot, Parris Island. The drawing has not been field verified and may not be at the indicated scale.